


Owner Name	Consent Number

Project Location

Details – Plumber/Drainlayer	Registration Number

A139541

Plan Example

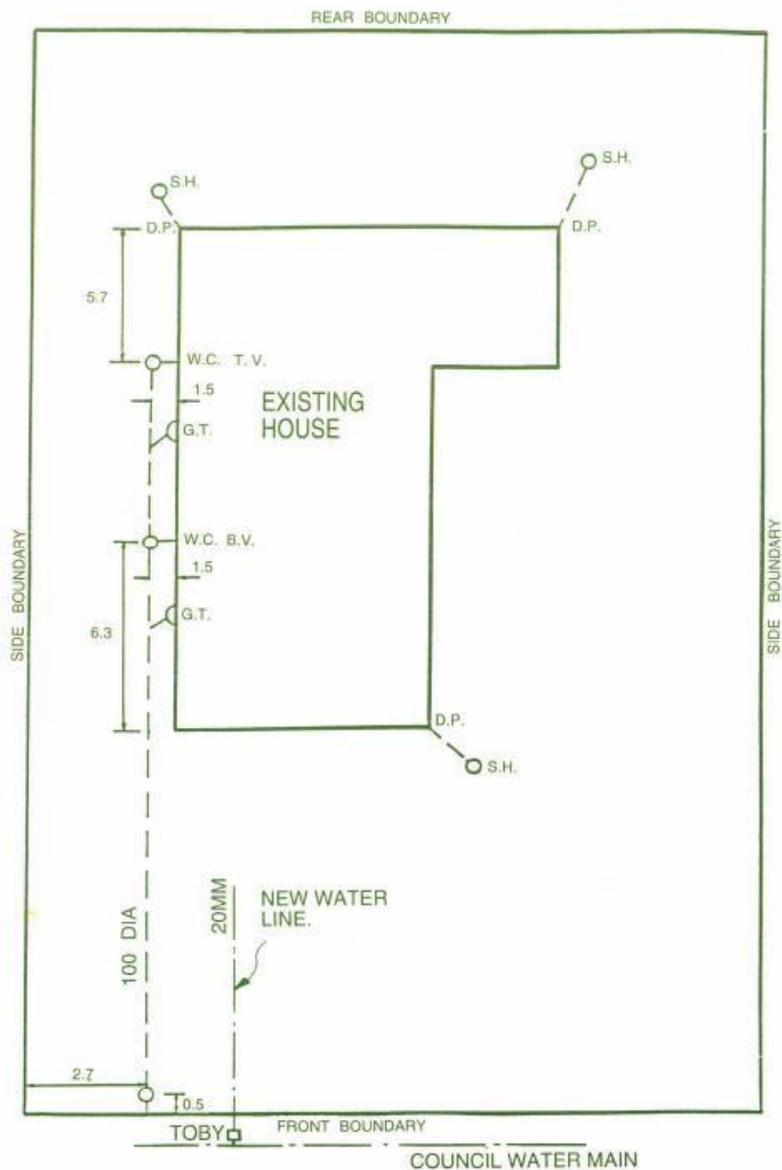

Draw plan in black ballpoint on graph

Plan is to show:

1. All drains in correct position relative to building and boundaries.
2. The road frontage.
3. Depth of drains at connection points.
4. All foulwater and stormwater drains.
5. All inspection openings, accurately dimensioned.
6. All buildings and boundaries.
7. Outside mainwater lines and the source of supply.

Please refer to example above.

A139541